


DATE: 12/04/2023
 23:34:13
 SCALE: AS
 SHOWN
 DRAWN BY: HTA


NEW RESIDENCE
8504 Wendy Street
 Clinton, Maryland
 ARCHITECT: TIRTANADI ARCHITECT
 HTA@TIRTANADIARCHITECT.COM
 STRUCTURAL: POTOMAC ENGINEERING
 LLO@POTOMACENGINEERING.COM

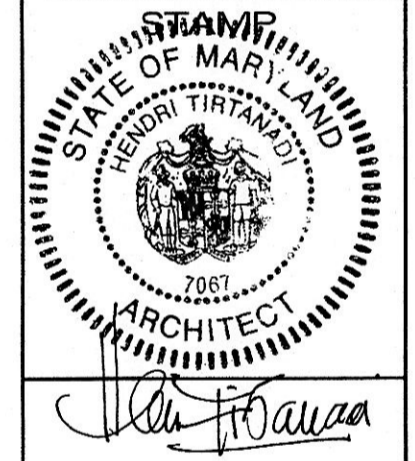

PAGE TITLE:
MAIN FL. PLAN

SHEET NO.
A3

P.G.C.
 Structural
 DPIE
 APPROVED AS NOTED
 BY BUILDING
 SECTION

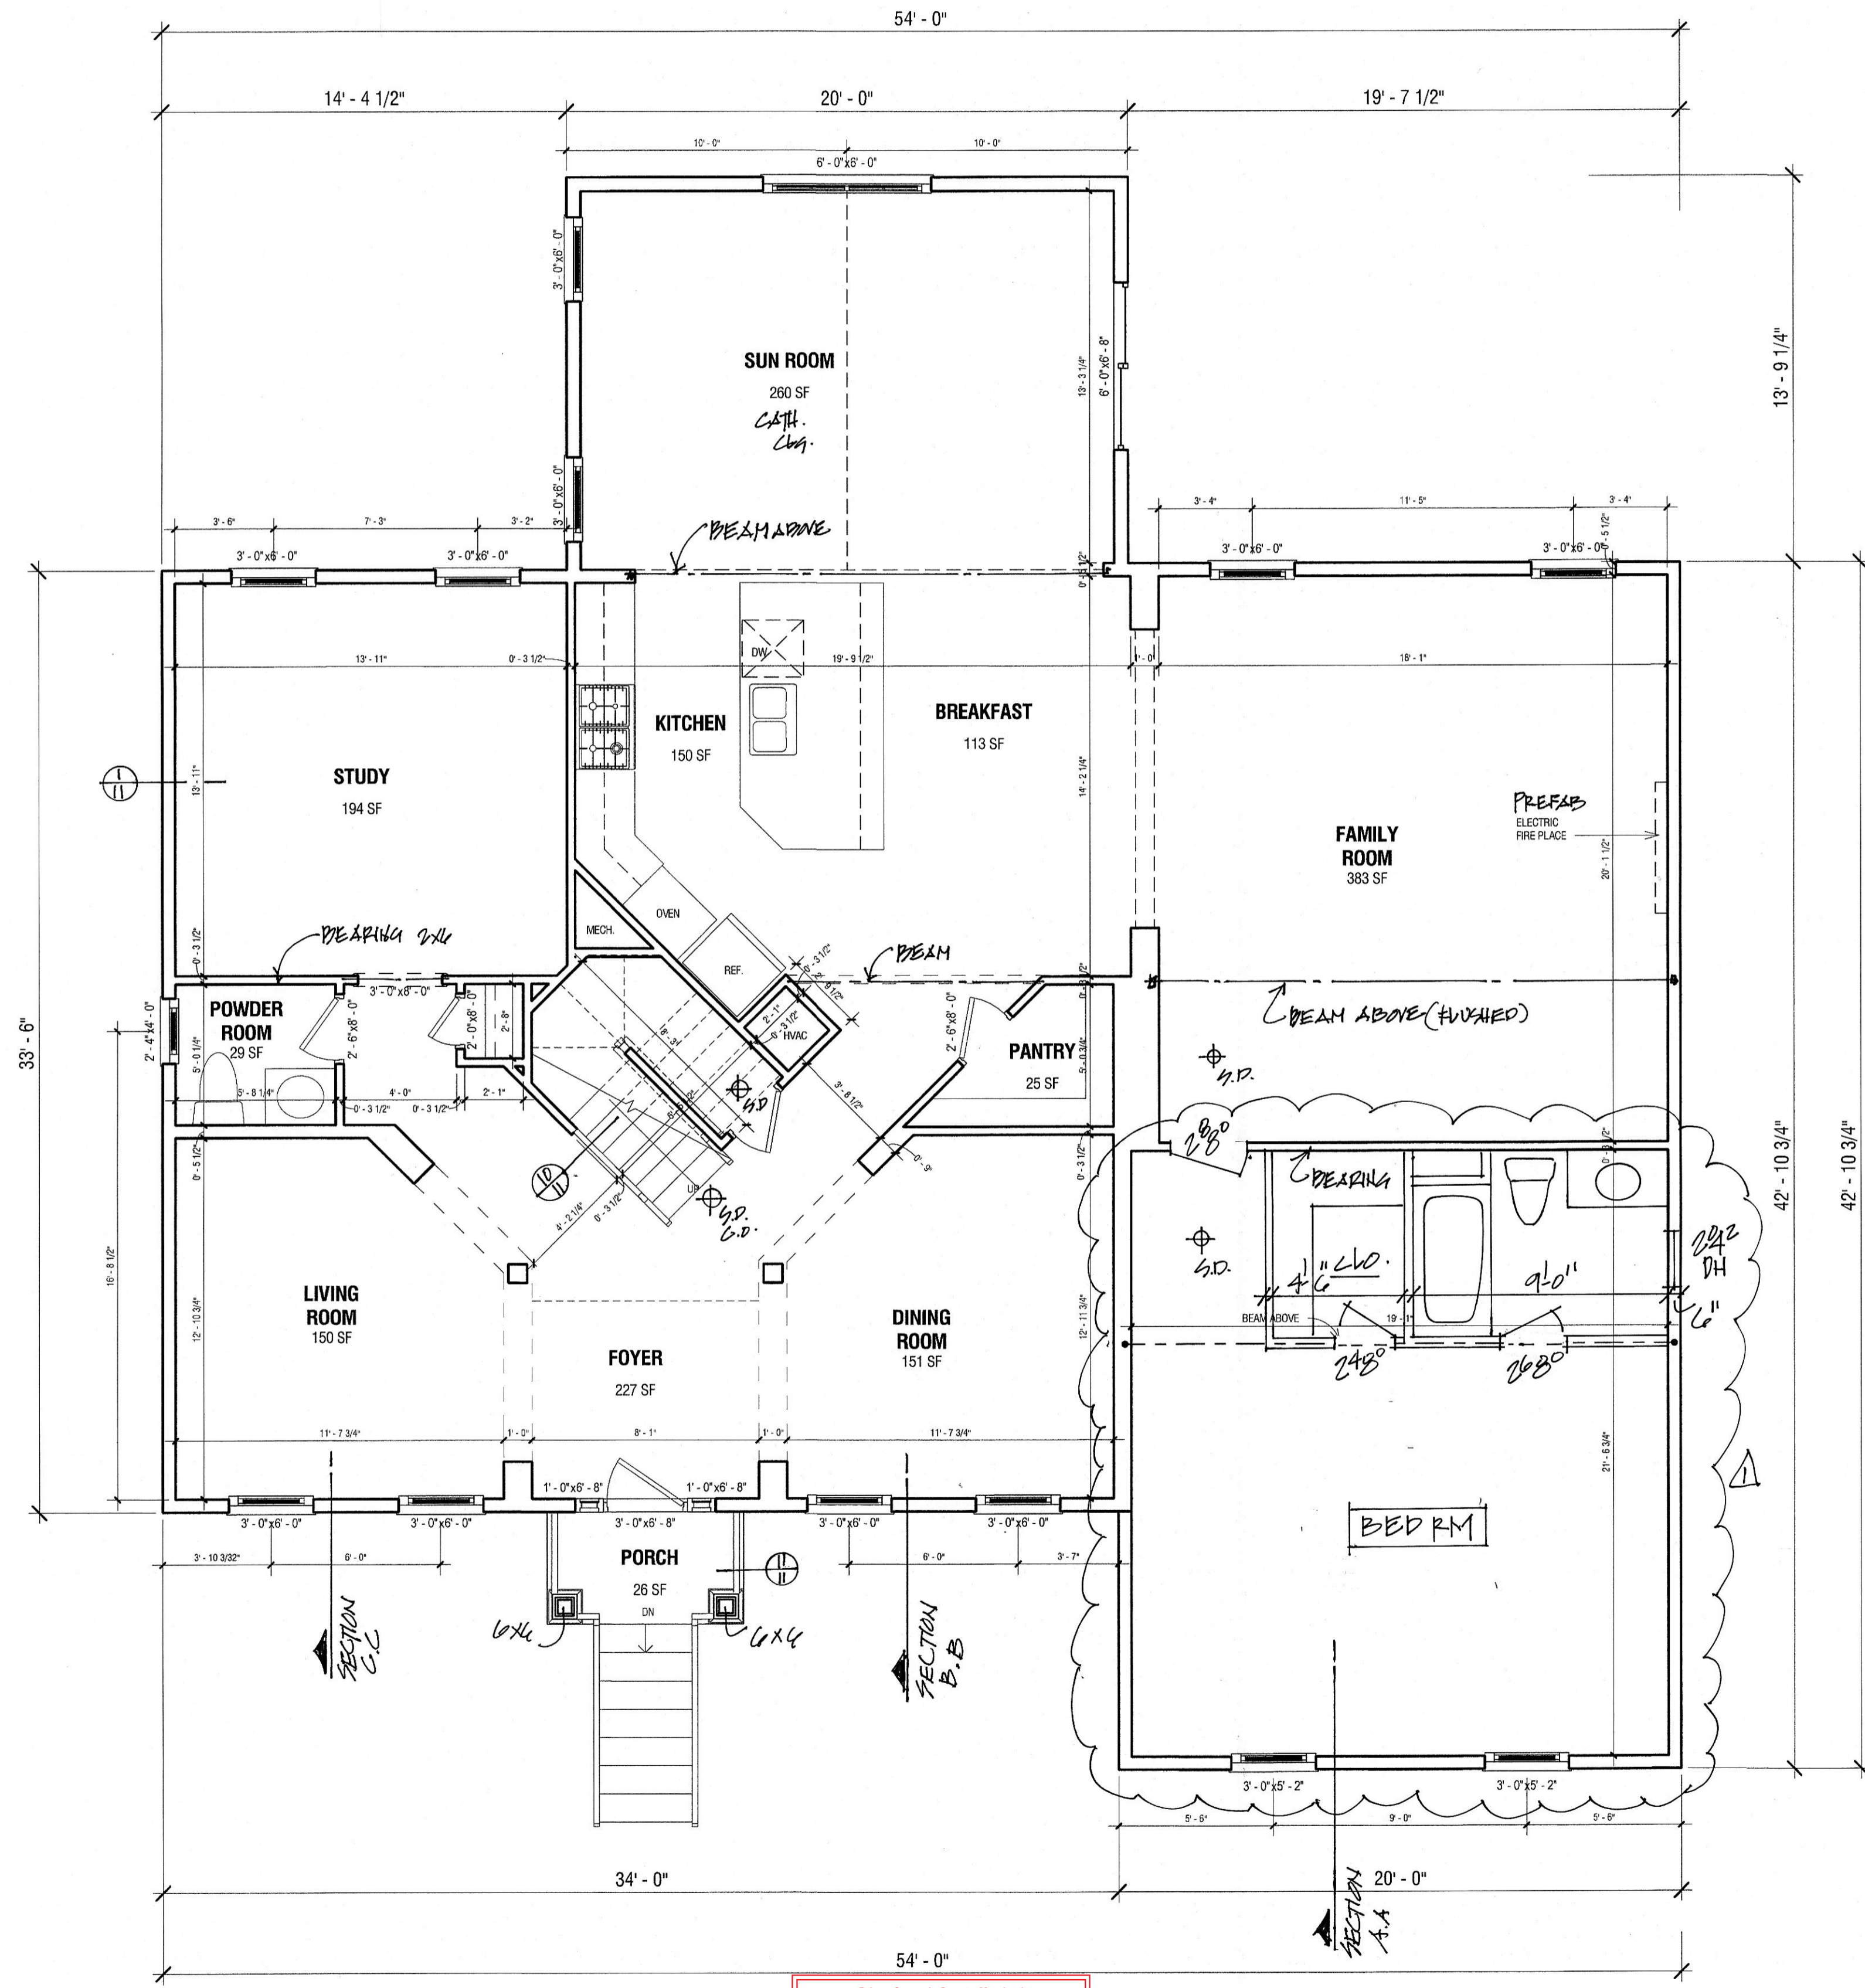

NOTE:
 SEE STRUCTURAL
 DRAWINGS FOR
 BEAM SIZES &
 HEADERS

APPROVAL 8/8/23
 A/16/23

MAIN FLOOR
 1552 SF LIVING SPACE

1 MAIN FL. PLAN
 A3 SCALE 1/4" = 1'-0"

Prince George's County, Maryland
 Department of Permitting, Inspections and Enforcement
APPROVED PERMIT SET
 The Department of Permitting, Inspections and Enforcement has
 completed a review of this document for code compliance. As
 required by State Code, the design professional(s) responsible for the
 preparation and content of this document must provide a
 second copy of these documents with their original seal, signature
 and date.
 Case Name: 2023030301 FORD HAYENFORD HOMES
 Case Number: WPMR19188452615-1707900
 Case Type: SGU
 Issuance Date: 11/09/23
 Address: LANCASTER UPHILL, LANCAST UP 8504
 WENDY ST CLINTON, Maryland 20735
 Lot(s), Block(s) and Parcel(s): Lot 1 and Block D
 DPIE